

Floor 9

Suite 960

~1,357 SQFT

Low-Rise — As Built



- 3 Window Line Offices
- 1 Conference Room
- 1 Open Work Area
- 1 Break Room
- 1 Server Closet

Jim Collins

jcollins@shorenstein.com

(415) 352-7239

Lic. #00860991

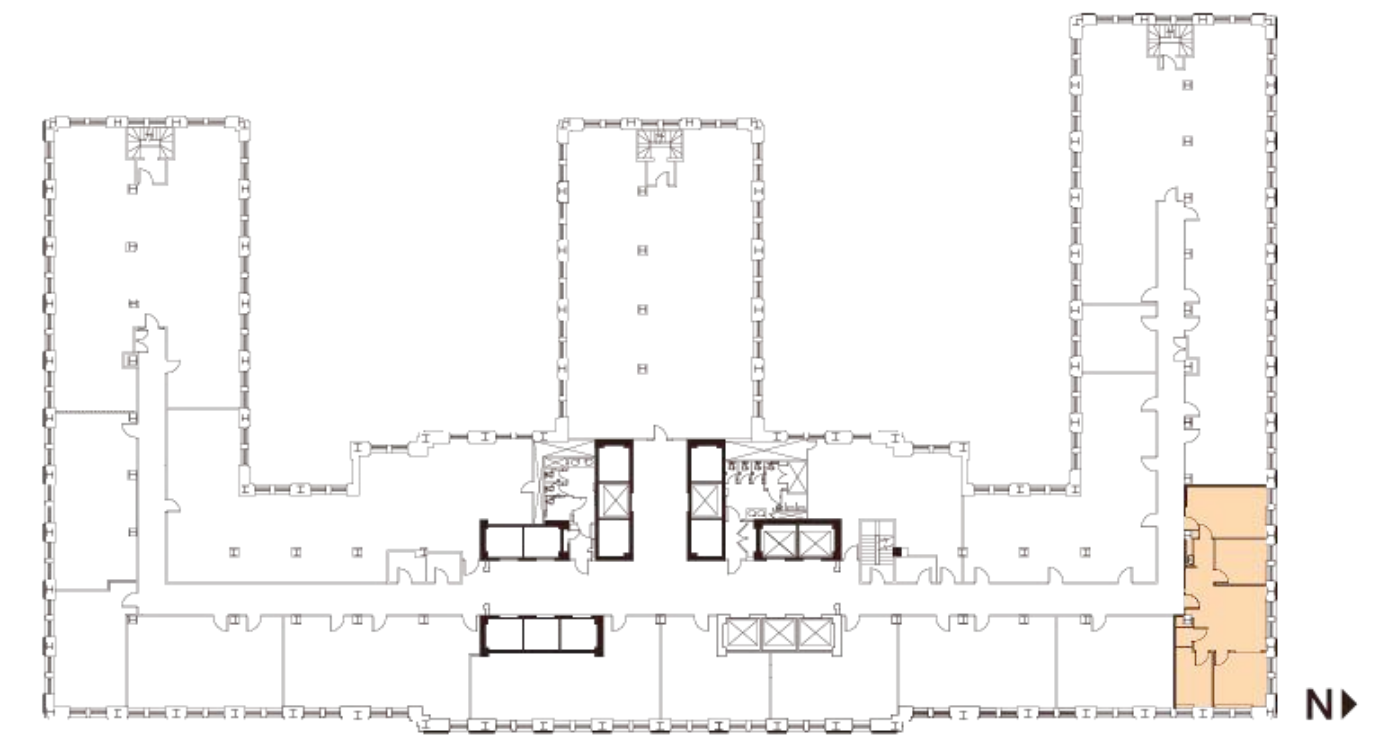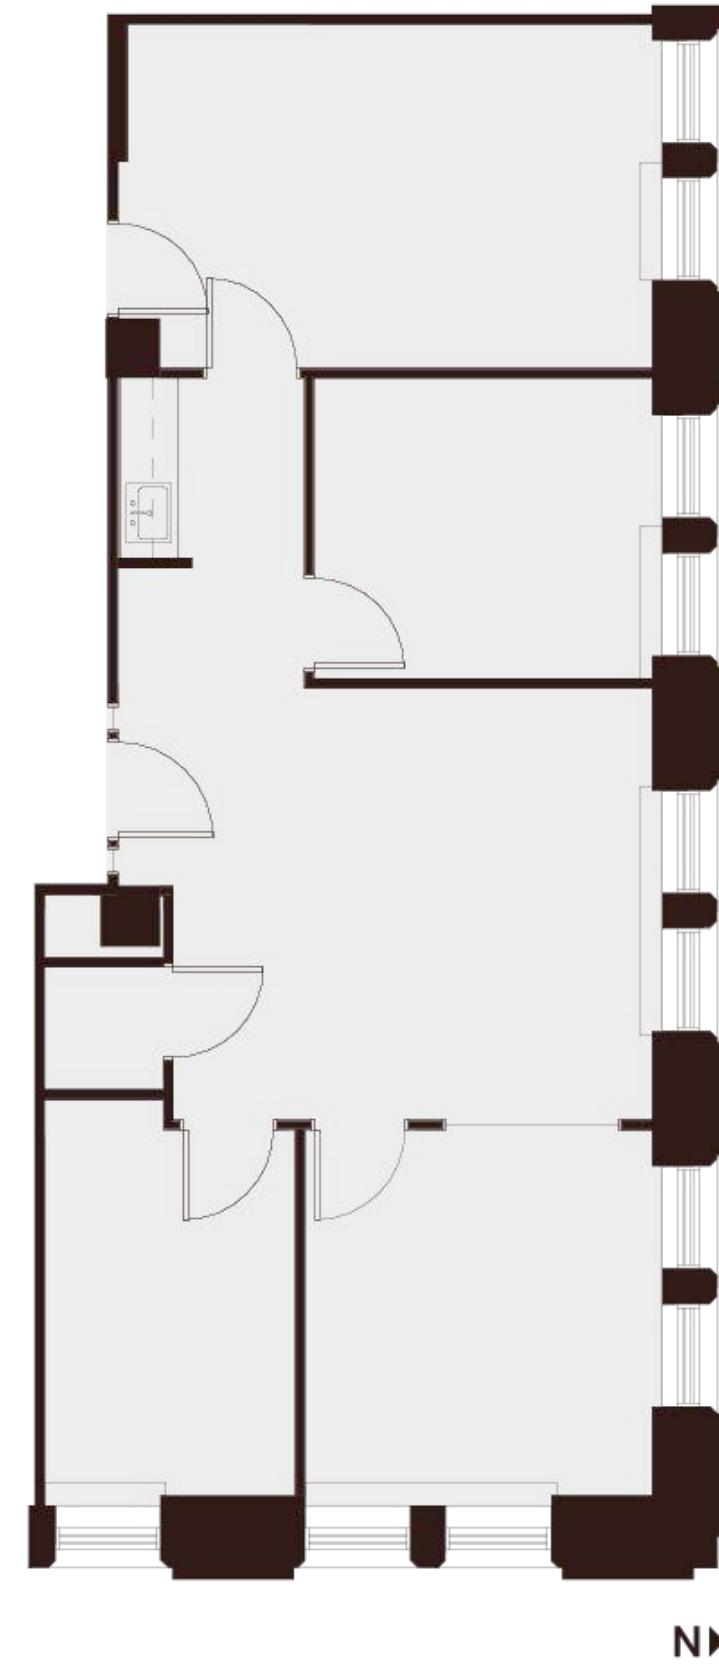

Montgomery Street



235 Montgomery St. San Francisco, CA 94104

